

PROPOSED NEW UPDATED LOOK



(E) SOUTH ELEVATION


SCALE: 1/4" = 1'-0"

DOOR SCHEDULE					
NUMBER	QTY	FLOOR	WIDTH	HEIGHT	DESCRIPTION
D01	1	1	132"	84"	GARAGE-16 GARAGEDOORBYDMDZ
D02	2	1	18"	80"	EXT. HINGED-DMD GLASS 4 PANEL ENTRY DOOR
D03	1	1	36"	80"	EXT. HINGED-DMD GLASS 4 PANEL ENTRY DOOR
D04	1	1	51"	80"	EXT. SLIDER-GLASS PANEL
D05	1	1	96"	84"	GARAGE-8 GARAGEDOORBYDMDZ

WINDOW SCHEDULE						
NUMBER	QTY	FLOOR	WIDTH	HEIGHT	EGRESS	DESCRIPTION
W01	1	2	60"	48"		LEFT SLIDING
W02	2	2	30"	48"		SINGLE CASEMENT-HR
W03	4	1	36"	48"		SINGLE HUNG
W04	1	2	48"	18"		SINGLE AWNING
W05	2	2	48"	48"		LEFT SLIDING
W06	2	2	69"	48"		LEFT SLIDING

ELEVATION NOTES"

1. PROPOSED NEW 4'x4' LEFT SLIDING WINDOW.
2. CRAFTSMAN STYLE SHUTTERS FOR ALL AVAILABLE FRONT FACING 2ND FLOOR WINDOWS.
3. COMPOSITE CEMENT SIDING / TEAL GREEN / E5R-2290
4. BOARD AND BATTEN TO WRAP BATHROOM WINDOW WALL.
5. OPTIONAL WOOD LATTICE PAINTED WHITE AND MOUNTED TO (E) ROOFLINE AND FRONT BRICK COLUMNS.
6. SHUTTERS (SEE NOTES #2)
7. BOARD AND BATTEN E5R-1844 / TEAL GREEN
8. WHITE CORNER BOARDS
9. REPLACE (E) GARAGE DOORS WITH NEW MODERN CRAFTSMAN STYLE DOORS. SEE HOME OWNER FOR DETAILS.
10. (E) BRICK COLUMNS, NOT TO CHANGE.
11. POSSIBLE NEW FRONT WOOD GATE (SEE HOME OWNER FOR DETAILS)

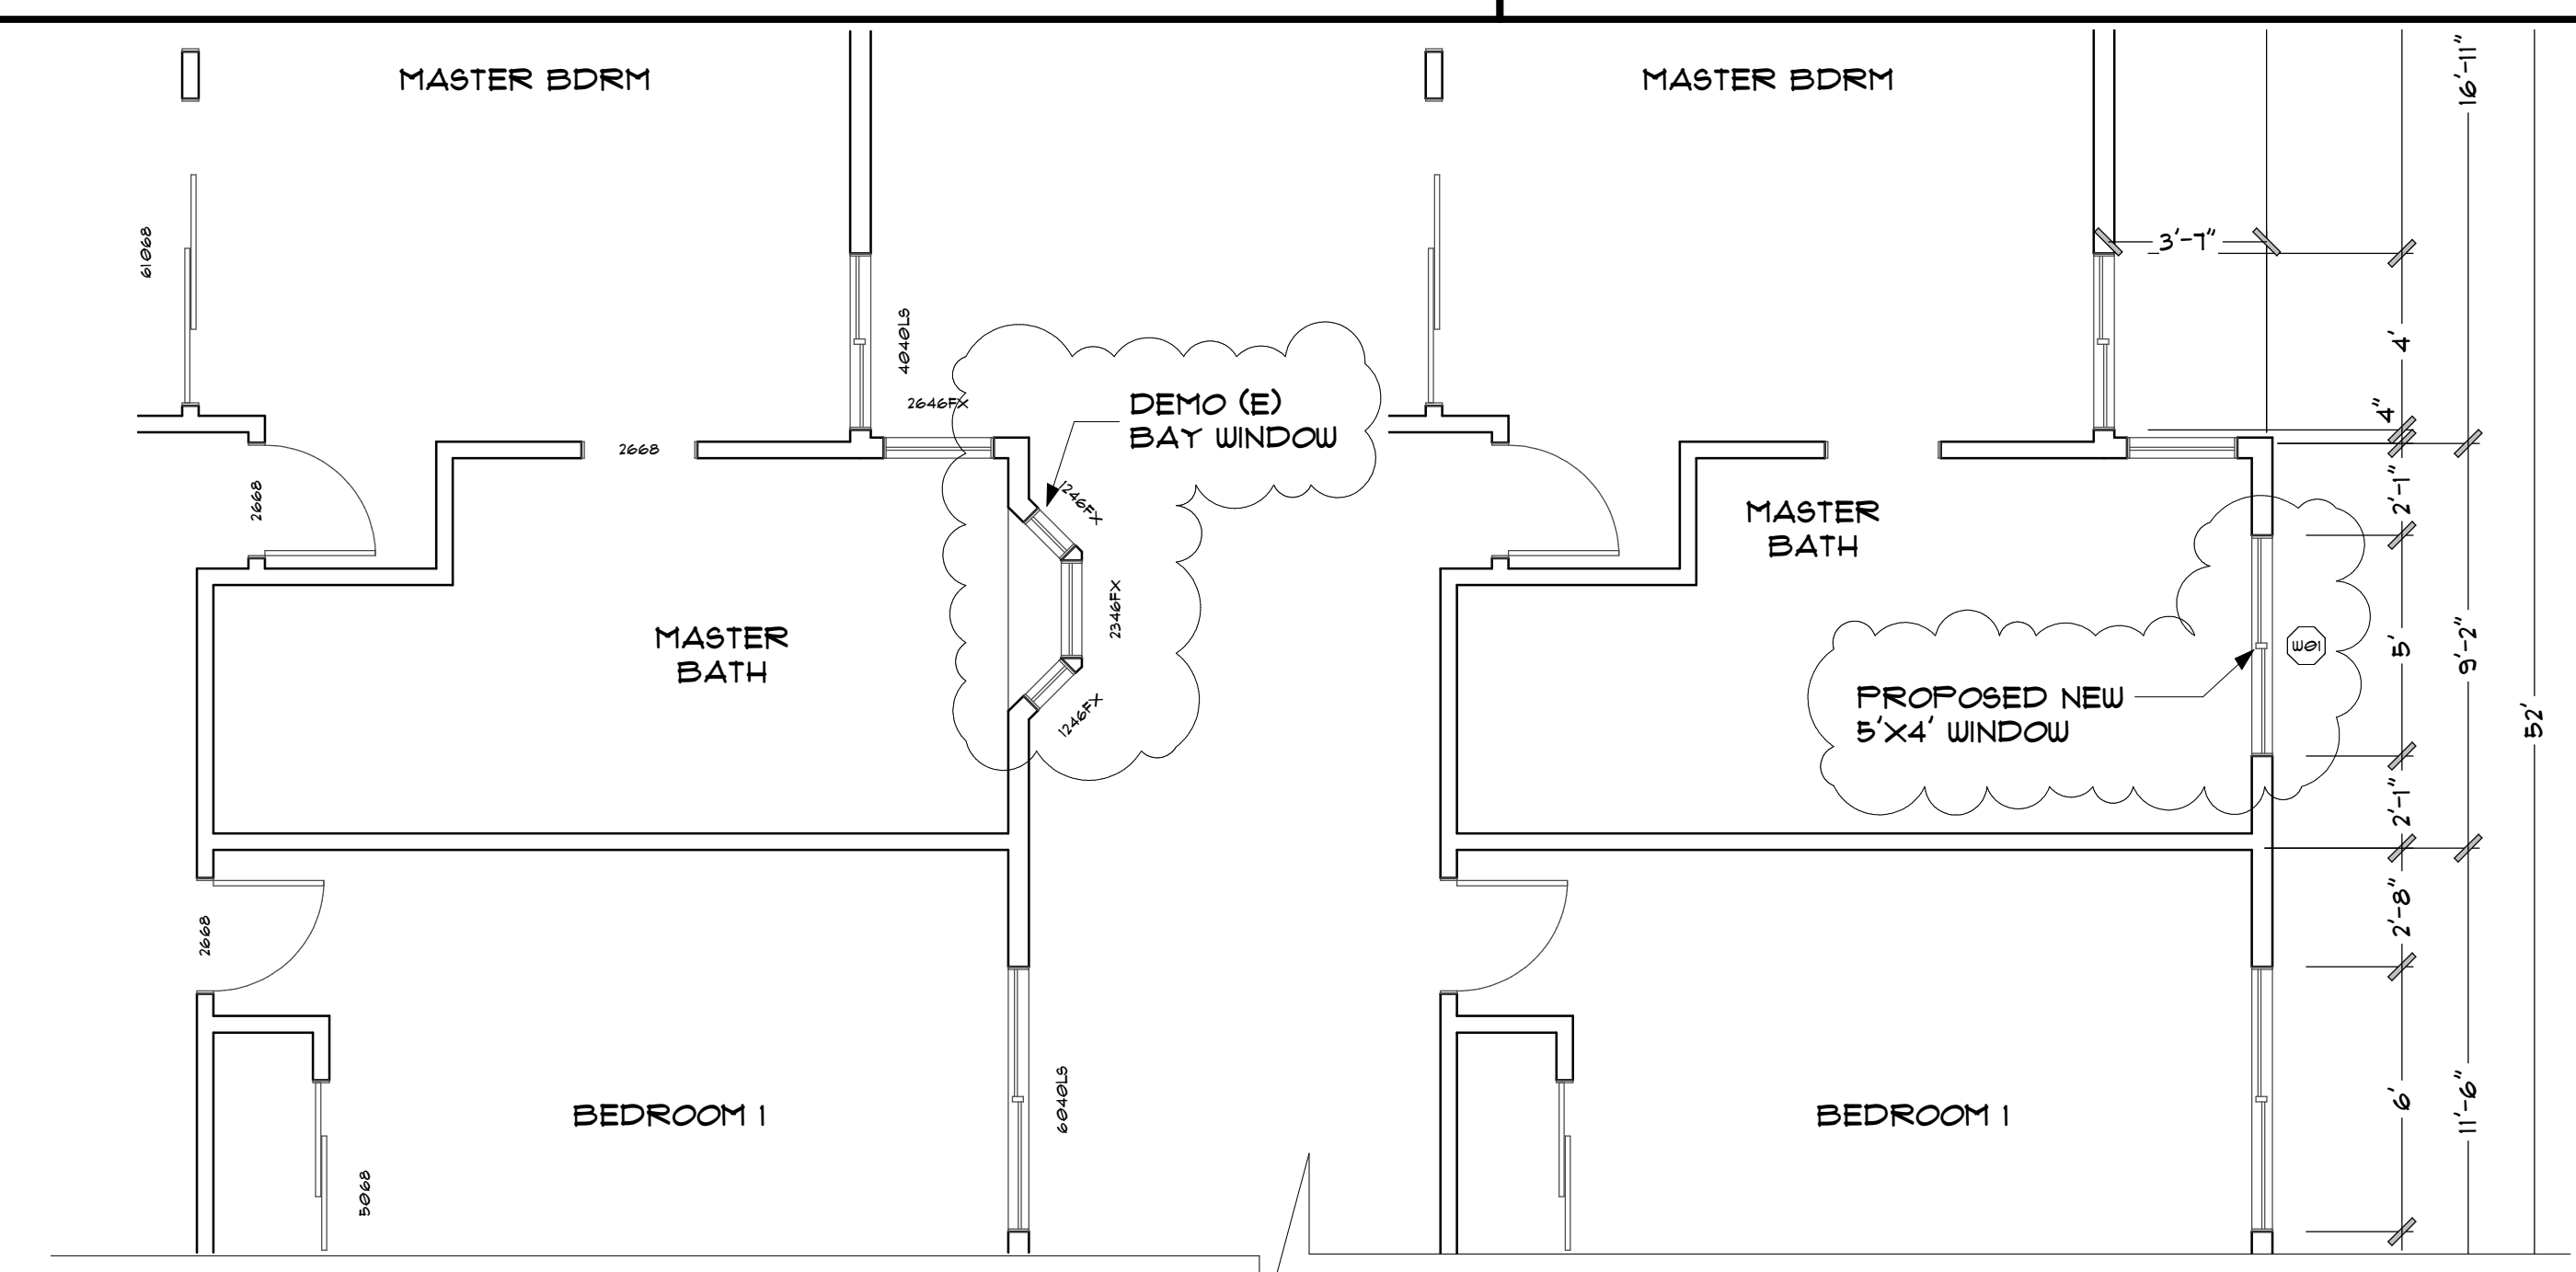

(E) 2ND FLOOR

PROPOSED 2ND FLOOR

PROPOSED PLAN

SCALE: 1/4" = 1'-0"

4



DAVID MICHAEL DESIGNS
 712 CENTER STREET COSTA MESA, CA 92627
 PH: 949.501.5535 FAX: 949.650.2192
 EMAIL: DAVIDMICHAELDESIGNS@GMAIL.COM

REVISIONS

NO.	DESCRIPTION
1	
2	

THIS SET OF CONSTRUCTION DOCUMENTS, INCLUDING ALL TITLES AND DESIGNS, ARE THE PROPERTY OF DAVID MICHAEL DESIGNS (DMCD) AND IS NOT TO BE USED IN EITHER ENTIRETY OR PARTIALLY FOR ANY OTHER PROJECTS WITHOUT THE WRITTEN AUTHORIZATION OF DAVID MICHAEL DESIGNS (DMCD). THE REPRODUCTION OR MODIFICATION OF THIS DOCUMENT WITHOUT THE PRIOR WRITTEN CONSENT OF DMCD IS PROHIBITED. THIS DOCUMENTATION INCLUDES NEW WORK AND DOES NOT NECESSARILY INCLUDE AS-BUILT OR EXISTING CONDITIONS. DMCD IS NOT WARRANTING IN ANY WAY THE ACCURACY OF THIS INFORMATION AND SHALL NOT BE RESPONSIBLE FOR ANY DISCREPANCY BETWEEN THIS DOCUMENT AND EXISTING CONDITIONS.

DAVID & MARILYN GARABOLDI
5871 CARBECK DR,
HUNTINGTON BEACH, CA 92648

HOME OWNER:

4	PROPOSED
TITLE	PROPOSED
DATE	3/5/2021
SCALE	1/4" = 1'-0"
ARTIST	DAVID MICHAEL DESIGNS

David Michael

SHEET

A4